


FLOOR PLAN
SCALE: 1/8" = 1'-0"



KEY PLAN
SCALE: 1/16" = 1'-0"

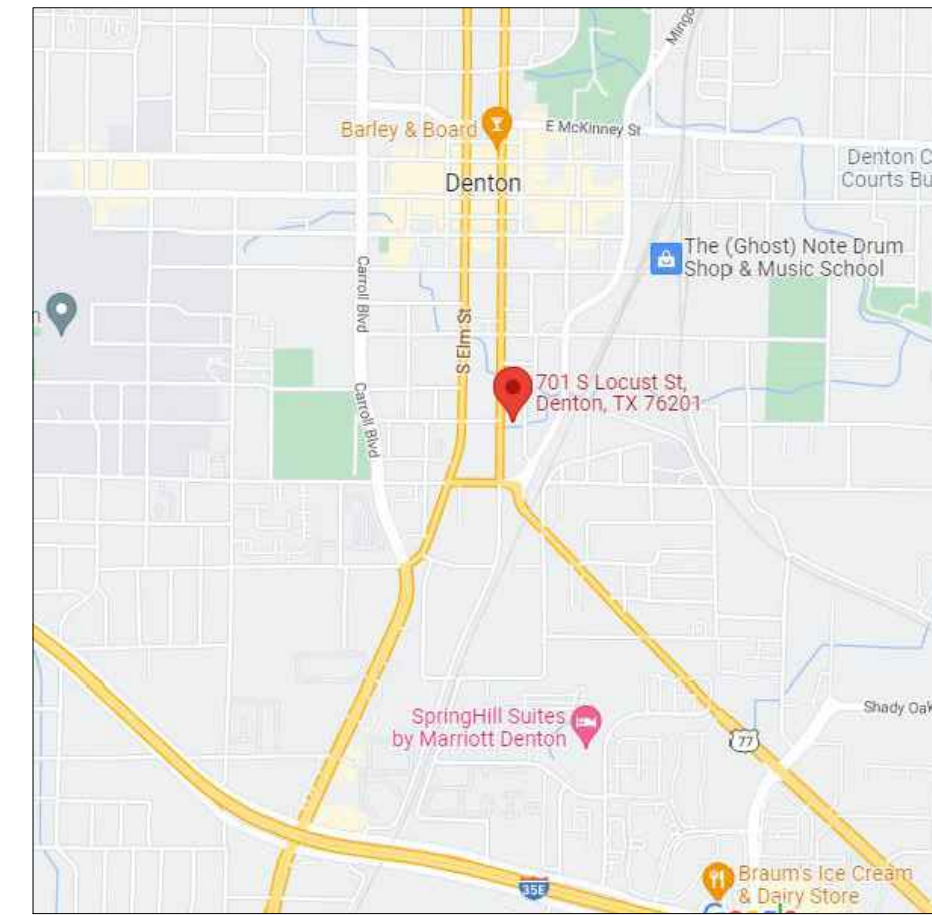

LOCATION MAP
SCALE: N.T.S.



NOTE: ALL NEW CONSTRUCTION SHALL COMPLY WITH THE TEXAS ACCESSIBILITY STANDARDS

NOTE: CONTRACTOR ENSURE THAT ALL NEW CONSTRUCTION SHALL COMPLY WITH APPLICABLE CITY CODE

CLIENT:

PROJECT:

**701 S. LOCUST STREET
DENTON, TEXAS**

TITLE:

REMODEL PLAN

SCALE: **AS NOTED**

(when printed on 18x24 paper)

DATE:

6/28/22

REVISION:

2

SHEET:

A-1